LABOR AND MATERIALS

1	Copper ~~Lead~~ — Connection	3/4	$ 2.80
1	Curb — Clock / Valve / T. S. & V.	3/4 in.	$ 3.60
1	Service box Old returned — Short 3½X4½ / Long 4½X5½ / Buff or Rdway		$ 5.80
9 Ft.	3/4 in. — Copper / Galv. Iron / Cast Iron — Pipe at 35		$ 3.15
	Nipples ... in. at		$
	Bushings ... to ... in. at		$
	Red'g / Inc'g — Couplings ... to ... in. at		$
	Union ... in. at		$
	Meter ... in. at		$
	Lead Joints at		$
	Compound Joints at		$
	Hrs. Foreman at		$
1	Hrs. Chauffeur at	91	$ 91
2	Hrs. Tapper at	91	$ 1.82
11	Hrs. Labor at	80	$ 9.20
	Hrs. Labor at		$
1	Hrs. Compressor at	87½	$ .88
	Compensation Ins.		$ .25
	Trucking		$ 1.—
	Builders Use of Water		$ 5.80
	Tap & Magnum		$
			$
			$
			$
			$ 34.81

1940-47

St. Sanford Pl. Ave. No. 70

Name of Owner

Mrs Hearld

Labor and Mat'l. Report Oct 23 19 47

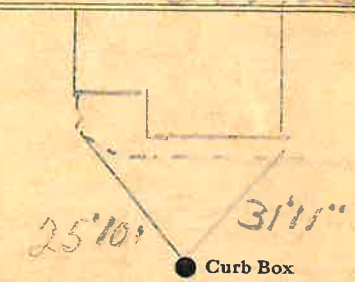

6 Main — Elev. of Main at tap 7

Gate at ● ● Gate at

TAX ID # 302.16-7-11

● Curb Box

9' to main

3/4" copper

LSM-5C-6-1-45