Labor and Materials

1	Lead Connection 3/4	$
1	Curb Cock 1	$
1	Service Box {Short 3½ x 4½ / ~~Old returned~~ ~~Long 4½ x 5½~~ / Buffalo}	$
7	Ft. 1 in. G. I. Pipe at	$
	Nipples ... in. at	$
	Bushings ... to ... in. at	$
	Red'g Coup ... to ... in. at	$
	Inc'g Coup ... to ... in. at	$
	Union ... in. at	$
	Meter ... in. at	$
	Cu. Yds. Br. Stone at	$
	Cu. Yds. Sand at	$
	Bags Cement at	$
	Paving Brick {Mack / Red / Asphalt} at	$
3	Hrs. Foreman at	$
6	Hrs. Common Labor at	$
	Hrs. Mason at	$
	Hrs. ... at	$
	Hrs. ... at	$
80	Builders' Use of Water	$
	... at	$
	Truck 106 ... at	$
	... at	$
	... at	$

Total $ 12.27

Labor and Material Report 12 April 1924

80
64 Sanford St. 3/4" tap

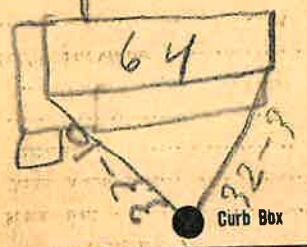

6" Main — Elev. of Main at tap 5

Gate at ● TAX ID # 302.16-8-5 ● Gate at

● Curb Box

7' to MAIN

3/4" GPK.