LABOR AND MATERIALS

1 Copper Lead	Connection 3/4	$ 1.35
1 Curb — Cock Valve T. S. & V.	3/4 in.	$ 1.80
1 Service Box Old returned	Short 3½x4½ / Long 4½x5½ / Buffor Rdway	$ 1.70
26 Ft. 3/4 in.	Copper / Galv Iron / Cast Iron Pipe at 18	$ 4.86
Nipples in. at		$
Bushings to in. at		$
Red'g Inc'g Couplings to in. at		$
Union in. at		$
Meter in. at		$
Lead Joints at		$
Leadite Joints at		$
Hrs. Foreman at		$
3 Hrs. Chauffeur at 62½		$ 1.87
1 Hrs. Tapper at ~		$ .63
16 Hrs. Labor at .45		$ 7.20
Hrs. Labor at		$
Hrs. Compressor at		$
1 Compensation Ins. 62½		$ .63
Trucking		$ .30
Builders Use of Water Patels		$ 5.—
Tax by Person		$
		$
		$
		$
		$ 25.34

8 6 1941

St. Pl. Ave. No. Sanford St 93

Name of Owner

Herbert D Triggs

Labor and Mat'l. Report Sept 2 1941

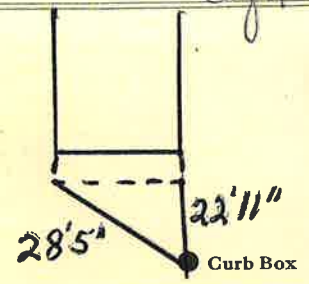

6 Main

Elev. of Main at tap 4½

Gate at ● ● Gate at

TAX ID# 302.16-13-13

● Curb Box

26' to MAIN

¾" COPPER