Labor and Materials

1	Copper / ~~Lead~~ Connection	3/4	$ 1.46
1	Curb Cock / ~~Valve~~ / ~~T. S. & V.~~ in	3/4	$ 1.93
1	Service Box Old returned Short 3½ x 4½ / ~~Long~~ 4½ x 5½ / ~~Buff.~~ or Rdway	4	$ 1.77
8	Ft. 3/4" in. Copper / ~~Galv Iron~~ / Cast Iron Pipe at	3/4	$ 1.76
	Nipples in. at		$
	Bushings to in. at		$
	Red'g / Inc'g Conplings to in. at		$
	Union in. at		$
	Meter in. at		$
	Lead Joints at		$
	Leadite Joints at		$
	Hrs. Foreman at		$
2	Hrs. Chauffeur at 62½		$ 1.25
	Hrs. Tapper at		$
12	Hrs. Labor at 45		$ 5.40
	Hrs. Labor at		$
	Hrs. Compressor at		$
	Compensation Ins.		$ .21
	Trucking		$ 1.00
	Builders Use of Water Patch (O.C.)		$ 10.00
			$
			$
			$
	Tap by Person		$
			$ 24.78

107-1937

Sanford St. Pl. Ave. No. 98

Name of Owner

St. John

Labor and Mat'l. Report Oct 22, 1937

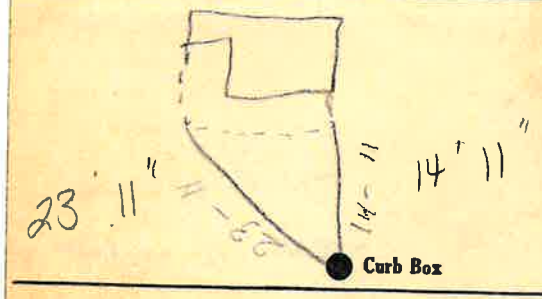

6 Main

Elev. of Main at tap 5½

Gate at • TAX ID # 302.12-22-14 • Gate at

● Curb Box

8' to main

3-9-92 - a new 3/4" copper line installed from curb box to main