LABOR AND MATERIALS

1	Copper Lead — Connection	3/4"	$2.94
1	Curb — Clock ~~Valve~~ ~~T. S. &~~ V.	3/4 in.	$3.71
1	Service box Old returned	Short 3½X4⅝ Long 4½X5⅝ Buff or Rdway	$5.90
24	Ft. 3/4 in.	Copper ~~Galv. Iron~~ ~~Cast Iron~~ Pipe at 30	$7.20
	Nipples in. at		$ .1
	Bushings to in. at		$
	Red'g Inc'g Couplings to in. at		$
	Union in. at		$
	Meter in. at		$
	Lead Joints at		$
	Compound Joints at		$
	Hrs. Foreman at		$
1	Hrs. ~~Chauffeur at~~ WMM-2	91	$5.46
	Hrs. Tapper at		$
9	Hrs. Labor at	80	$7.20
	Hrs. Labor at		$
2	Hrs. Compressor at	1.20	$2.40
	Compensation Ins.		$ .29
	Trucking		$1.00
	Builders Use of Water		$2.00
	Apply Maguire		$
			$
			$
			$
			$4409

29

St. ~~Pl.~~ Ave. No. 99

Name of Owner

Jones

Labor and Mat'l. Report April 26 1945

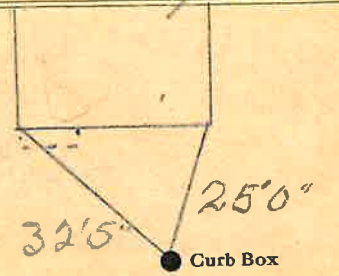

6 Main — Elev. of Main at tap 5½

Gate at ● ● Gate at

TAX ID # 302.16-13-10

● Curb Box

24' to main
3/4" copper

LSM-5C-6-1-45