Labor and Materials

Cop

- Lead Connections 3/4 ..... $
- 1 Curb Cock 3/4 ..... $
- 1 Service Box { Short 3½ x 4½ / ~~Long 4½ x 6½~~ / Buffalo } Old returned ..... $
- 23 Ft. — in. G. I. Pipe at Copper ..... $
- Nipples ..... in. at ..... $
- Bushings ..... to ..... in. at ..... $
- 1 [illegible] Coup ..... to ..... in. at ..... $
- Inc'g Coup ..... to ..... in. at ..... $
- Union ..... in. at ..... $
- Meter ..... in. at ..... $
- Cu. Yds. Br. Stone at ..... $
- Cu. Yds. Sand at ..... $
- Bags Cement at ..... $
- Paving Brick { Mack / Red / Asphalt } at ..... $
- Hrs. Foreman at ..... $
- 18 Hrs. Common Labor at ..... $
- Hrs. Mason at ..... $
- Hrs. ..... at ..... $
- Hrs. ..... at ..... $
- N1 Builders' Use of Water ..... $
- ..... at ..... $
- ..... at ..... $
- ..... at ..... $
- ..... at ..... $

Total $ 17.91

Labor and Material Report Aug 1925

~~107~~ 83 SANFORD ST

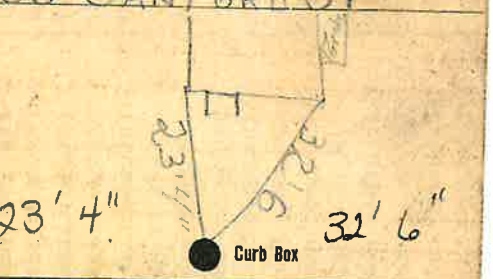

6" Main — Elev. of Main at tap 5½

Gate at — Gate at

TAX ID # 302.12-27-15

Curb Box

23' to main
3/4" copper