LABOR AND MATERIALS

1	Copper Lead — Connection	3/4"	$ 2.41
1	Curb — Clock Valve T. S. & V.	3/4 in.	$ 3.41
1	Service box Old returned — Short 3½X4½ ~~Long 4½X5½~~ ~~Buff or Rdway~~		$ 4.18
24 Ft.	3/4 in. — Copper ~~Galv. Iron~~ ~~Cast Iron~~	Pipe at 40	$ 9.60
	Nipples ... in. at		$
	Bushings ... to ... in. at		$
	Red'g Inc'g Couplings ... to ... in. at		$
	Union ... in. at		$ 8.91
	Meter ... in. at		$
	Lead Joints at		$
	Compound Joints at		$
2	Hrs. Foreman at	1.51	$ 3.02
	Hrs. Chauffeur at		$
	Hrs. Tapper at		$
12	Hrs. Labor at	1.13	$ 13.56
	Hrs. Labor at		$
	Hrs. Compressor at		$
	Compensation Ins.	3.96%	$ .64
	Trucking		$ 1.50
	Builders Use of Water		$ 9.10
	Tap made by Miller — Dec 23 '53		$
			$
			$
			$
			$ 44.12

3.32

5 - 54

St. Pl. Ave. No. Sanford 111

Name of Owner Albert Stewart

Labor and Mat'l. Report 12-23- Oct 26 19 53

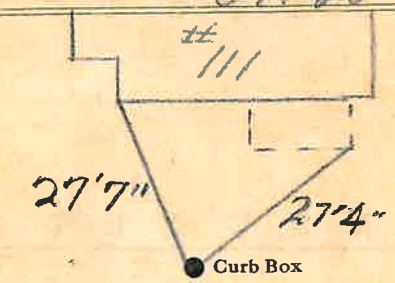

6" Main

Elev. of Main at tap 5'

Gate at ● ● Gate at

TAX ID # 302.12-27-13

● Curb Box

24' to MAIN
3/4" COPPER

LSM-5C-6-1-45