LABOR AND MATERIALS

1	Copper Lead	Connection 3/4		$ 2.80
1	Curb { Clock Valve T. S. & V. }	3/4	in.	$ 3.60
1	Service box Old returned	{ Short 3½X4½ ~~Long 4½X5½~~ Buff or Rdway }		$ 5.80
22	Ft. 3/4 in.	{ Copper ~~Galv. Iron~~ ~~Cast Iron~~ }	Pipe at 35	$ 7.70
	Nipples	in. at		$
	Bushings	to in. at		$
	Red'g Inc'g	Couplings to in. at		$
	Union	in. at		$
	Meter	in. at		$
	Lead Joints at			$
	Compound Joints at			$
	Hrs. Foreman at			$
7	Hrs. Chauffeur at	91		$ 6.37
	Hrs. Tapper at			$
8	Hrs. Labor at	80		$ 6.40
	Hrs. Labor at			$
1	Hrs. Compressor at	87½		$ 88
	Compensation Ins.			$ 28
	Trucking			$ 1.—
	Builders Use of Water,			$
	Tap by Marshall			$ 2.70
				$
				$
				$
				$
				$ 41.53

13-47

St.
~~Pl.~~
Ave. No. 27

Sanford

Name of Owner

Sapulding

Labor and Mat'l. Report July 17 1947

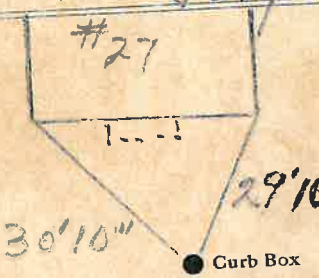

6" Main

Elev. of Main at tap 7'

Gate at ●

● Gate at

TAX ID # 302.16-11-15

● Curb Box

22' to MAIN
3/4" COPPER

LSM-5C-6-1-45