LABOR AND MATERIALS

1	Copper / ~~Lead~~ Connection 3/4	$ 1.35
1	Curb { Cock / ~~Valve~~ / ~~T. S. & V.~~ } 3/4 in.	$ 1.80
1	Service Box Old returned { Short 3½x4½ / ~~Long 4½x5½~~ / Buff or Rdway }	$ 1.70
22	Ft. 3/4 in. { Copper / ~~Galv Iron~~ / ~~Cast Iron~~ } Pipe at 18	$ 3.96
	Nipples ... in. at	$
	Bushings ... to ... in. at	$
	Red'g / Inc'g Couplings ... to ... in. at	$
	Union ... in. at	$
	Meter ... in. at	$
	Lead Joints at	$
	Leadite Joints at	$
	Hrs. Foreman at	$
4	Hrs. Chauffeur at	$ 2.50
7	Hrs. Tapper at	$ 4.37
6	Hrs. Labor at	$ 2.70
	Hrs. Labor at	$
1	Hrs. Compressor at 62½¢	$ .63
	Compensation Ins.	$ .30
	Trucking	$ 1.—
	Builders Use of Water Patch	$ 5.—
	Tap by Hessel	$
		$
		$
		$
		$ 25.31

2 8 1941

St. ~~Pl.~~ ~~Ave.~~ No. 117 Sanford

Name of Owner

Dorey

Labor and Mat'l. Report June 27 1941

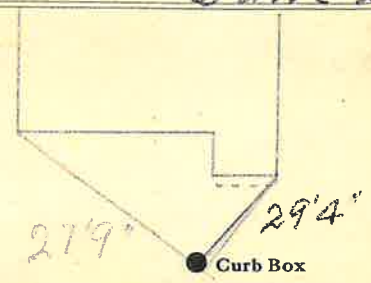

6 Main

Elev. of Main at tap 6

Gate at

Gate at

TAX ID# 302.12-27-10

Curb Box

22' to main
3/4" copper