LABOR AND MATERIALS

1	Copper Lead } Connection	3/4"	$ 3.20
1	Curb { Clock Valve T. S. & V. }	3/4" in.	$ 1.00
1	Service box Old returned { Short 3½X4½ Long 4½X5½ Buff or Rdway }		$ 1.40
11	Ft. 3/4 in. { Copper Galv. Iron Cast Iron } Pipe at 22		$ 2.42
	Nipples in. at		$
	Bushings to in. at		$
1	Red'g Inc'g } Couplings 3/4 to 1 in. at		$ .15
	Union in. at		$
	Meter in. at		$
	Lead Joints at		$
	Compound Joints at		$
2	Hrs. Foreman at 2.25		$ 1.25
	Hrs. Chauffeur at		$
	Hrs. Tapper at		$
3	Hrs. Labor at 50		$ 1.50
9	Hrs. Labor at 40		$ 3.65
	Hrs. Compressor at		$
	Compensation Ins.		$ .15
1	Trucking		$ 1.00
	Builders Use of Water.		$
			$
			$
			$
			$
			$ 15.22

St. Pl. Ave. No. 124

Sanford St

Name of Owner

Labor and Mat'l. Report Oct 26 1945

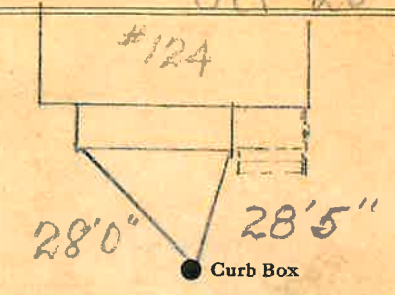

6" Main

Elev. of Main at tap 5'

Gate at ● ● Gate at

TAX ID # 302.12-13-3

● Curb Box

11' to main
3/4" copper

LSM-5C-6-1-45