LABOR AND MATERIALS

Copper / Lead } Connection ..... $.....

Curb { Clock / Valve / T. S. & V. } ..... in. ..... $.....

Service box Old returned { Short 3⅛X4⅛ / Long 4⅛X5⅛ / Buff or Rdway } ..... $.....

10 Ft. 3/4 in. { Copper / Galv. Iron / Cast Iron } Pipe at ..... $.....

Nipples ..... in. at ..... $.....

Bushings ..... to ..... in. at ..... $.....

Red'g / Inc'g } Couplings ..... to ..... in. at ..... $.....

Union ..... in. at ..... $.....

Meter ..... in. at ..... $.....

Lead Joints at ..... $.....

Compound Joints at ..... $.....

Hrs. Foreman at ..... $.....

Hrs. Chauffeur at ..... $.....

Hrs. Tapper at ..... $.....

Hrs. Labor at ..... $.....

Hrs. Labor at ..... $.....

Hrs. Compressor at ..... $.....

Compensation Ins. ..... $.....

Trucking ..... $.....

Builders Use of Water ..... $.....

..... $.....

..... $.....

..... $.....

..... $.....

$.....

Sanford St. St. Pl. Ave. No. 146

Name of Owner

Labor and Mat'l. Report Oct 26 1945

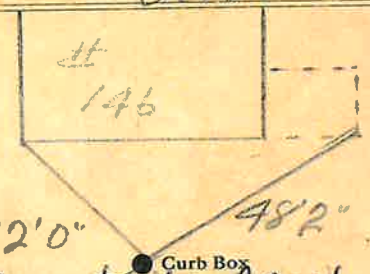

Curb Box outside of curb

Main Elev. of Main at tap .....

Gate at ● ● Gate at

TAX ID # 303.9-10-17

● Curb Box

10' to main

3/4" COPPER

LSM-5C-6-1-45