LABOR AND MATERIALS

1	Copper / ~~Lead~~ Connection	3/4"	$ 3.20
1	Curb — Cock / ~~Valve~~ / ~~T. S. & V.~~	3/4 in.	$ 1.00
1	Service box — Old returned — Short 3½X4½ / ~~Long 4½X5½~~ / ~~Buff or Rdway~~		$ 1.30
13	Ft. 3/4 in. — Copper / ~~G. I.~~ / ~~C. I.~~ Pipe at		$ 2.86
	Nipples ... in. at		$
	Bushings ... to ... in. at		$
	Red'g / Inc'g Coupl'gs ... to ... in. at		$
	Union ... in. at		$
	Meter ... in. at		$
	Lead Joints at		$
	Compound Joints at		$
	Hrs. Water Maint. Man—1 at		$
1	Hrs. ~~Water Maint.~~ Man—2 at		$ .63
2	Hrs. Labor— ... at		$ 1.00
2	Hrs. Labor— ... at		$ .81
	Hrs. Compressor at		$
	Compensation Ins. at $ ... per C		$ .06
	Trucking		$ 1.00
	Pav't Patch		$
			$
			$
			$
	O'head		$
			$ 11.86

Copy.

28-140

Sanford St. ~~Pl.~~ 172 Ave. No. ~~132~~

Name of Owner

Labor and Mat'l. Report Oct. 16 1928

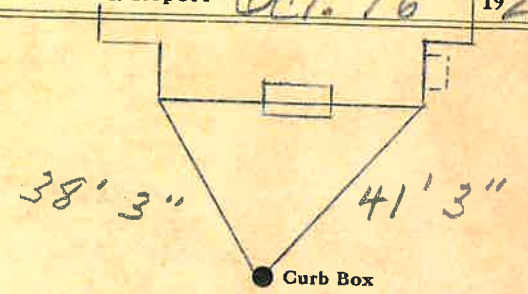

6" Main Elev. of Main at tap 4 1/2

Gate at ● ● Gate at

TAX ID # 303.9-11-14

● Curb Box

Old Tap Shut off
13' to main
3/4" copper

LSM-5C 8 15-48