LABOR AND MATERIALS

1	Copper / ~~Lead~~ Connection 3/4"	$ 2.76
1	Curb Cock / ~~Valve~~ / ~~T. S. & V.~~ 3/4 in.	$ 3.49
1	Service box ~~Old returned~~ Short 3½X4½ / ~~Long 4½X5½~~ / Buff or Rdway	$ 4.74
9	Ft. 3/4 in. Copper / ~~G. I.~~ / ~~C. I.~~ Pipe at 3.8	$ 34.2
	Nipples ..... in. at	$
	Bushings ..... to ..... in. at	$
	Red'g / Inc'g Coupl'gs ..... to ..... in. at	$
	Union ..... in. at	$
	Meter ..... in. at	$
	Lead Joints at	$
	Compound Joints at	$
	Hrs. Water Maint. Man—1 at	$ 2.76
7	Hrs. Water Maint. Man—2 at 1.24	$ 8.68
16	Hrs. Labor— ....at 1.13	$ 18.08
	Hrs. Labor— ....at	$
	Hrs. Compressor at	$
	Compensation Ins. at $4.40 per C	$ 1.18
	Trucking	$ 1.00
	Pav't Patch	$ 6.08
	Tap by Giggard 8-10-53	$
		$
		$
	O'head	$
		$ 49.43

43.35

St. ~~Pl.~~ Ave. No. 16

Sarella

Name of Owner

Henry

Labor and Mat'l. Report Aug. 10 1953

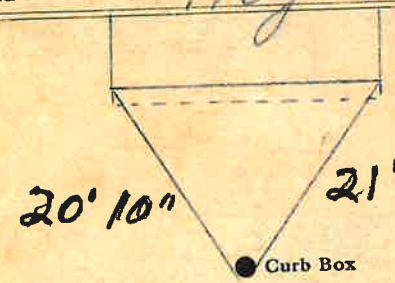

4" Main

Elev. of Main at tap 5½'

Gate at ●

● Gate at

TAX ID # 302.12-18-18

● Curb Box

Old house New Tap.

9' to main

3/4" copper

LSM-5C 5 15-48