Labor and Materials

1	Copper ~~Lead~~ Connection	3/4	$ 1.46
1	Curb Cock ~~Valve~~ ~~T. S. & V.~~	in 3/4	$ 1.93
1	Service Box Old returned ~~Short 3½ x 4½~~ Long 4½ x 5½ ~~Buff. or Ridway~~		$ 1.77
25 Ft.	3/4 in. Copper ~~Galv Iron~~ ~~Cast Iron~~ Pipe at		$ 5.50
	Nipples in. at		$
	Bushings to in. at		$
	Red'g Inc'g Couplings to in. at		$
	Union in. at		$
	Meter in. at		$
	Lead Joints at		$
	Leadite Joints at		$
1	Hrs. Foreman at	31¼	$ .31
8	Hrs. Chauffeur at	62½	$ 5.00
	Hrs. Tapper at		$
18	Hrs. Labor at	.45	$ 8.10
	Hrs. Labor at		$
	Hrs. Compressor at		$
	Compensation Ins.		$ .41
	Trucking		$ 1.00
	Builders Use of Water Estd.		$ 5.00
			$
			$
			$
	Tap made by Boon		$
			$ 30.48

2 4 - 1937

Sarella St. ~~Pl.~~ Ave. No. 11

Name of Owner

Adolf E Boon

Labor and Mat'l. Report May 18 1937

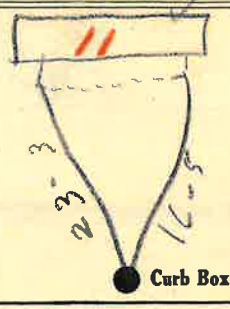

6 Main

Elev. of Main at tap 5½

Gate at • • Gate at

TAX ID # 302.12-26-4

● Curb Box

old tap shut off

25' to main

3/4" COPPER