Labor and Materials

1	Copper Lead — Connection	3/4	$ 1.46
1	Curb — Cock / Valve / T. S. & V.	3/4 in	$ 1.93
1	Service Box — Old returned — Short 3½ x 4½ / ~~Long 4½ x 5½~~ / ~~Buff. or Rdway~~		$ 1.77
4 7	Ft. 3/4 in. — Copper / ~~Galv Iron~~ / ~~Cast Iron~~ Pipe at		$ 1.54
	Nipples in. at		$
	Bushings to in. at		$
	Red'g Inc'g Couplings to in. at		$
	Union in. at		$
	Meter in. at		$
	Lead Joints at		$
	Leadite Joints at		$
1	Hrs. Foreman at	3 1/4	$ .31
9	Hrs. Chauffeur at	6 2½	$ 5.63
2	Hrs. Tapper at	6 2½	$ 5.00
8	Hrs. Labor at	.45	$ 3.60
	Hrs. Labor at		$ 14.54
	Hrs. Compressor at		$
	Compensation Ins.		$ .45
	Trucking		$ 1.00
	Builders Use of Water	Patch	$ 10.00
			$
			$
	Tap made by Penn		$
	old Tap shut off by Penn.		$ 32.69

1-8-1937

St. Pl. Ave. No. 4

School

Name of Owner

Red Lion

Labor and Mat'l. Report April 20 19

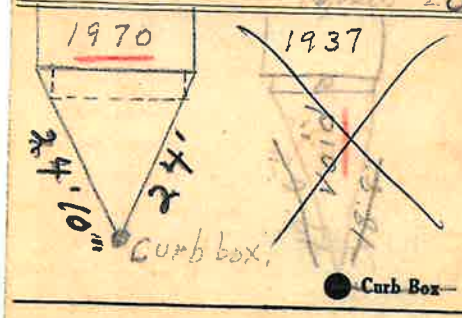

6" C.I. - 1970

Main

Elev. of Main at tap 4'

Gate at • • Gate at

• Curb Box

old top shut off

old Tap had to be dug up and shut off api 22-37

4' to MAIN

3/4" COPPER