Labor and Materials

1	Copper ~~Lead~~ Connection		$ 1.23
1	Curb { Cock ~~Valve~~ ~~T. S. & V.~~ }	3/4 in	$ 1.68
1	Service Box ~~Old returned~~ { ~~Short 3½ x 4½~~ Long 4½ x 5½ ~~Buff or Rdway~~ }		$ 1.75
22 Ft.	3/4 in. { Copper ~~Galv Iron~~ ~~Cast Iron~~ }	Pipe at .15	$ 3.30
	Nipples	in. at	$
	Bushings	to in. at	$
	Red'g Inc'g { Couplings	to in. at	$
	Union	in. at	$
	Meter	in. at	$
	Lead Joints at		$
	Leadite Joints at		$
	Hrs. Foreman at		$
1½	Hrs. Chauffeur at 62½		$ .94
4	Hrs. Tapper at		$ 2.50
1½	Hrs. Labor at .50		$ .35
4	Hrs. Labor at .45		$ 1.80
1	Hrs. Compressor at 87½		$ .88
	Compensation Ins.		$ .17
	Trucking		$ .50
	Builders Use of Water Patch		$ 5.00
			$
			$
			$
			$
			$ 20.00

3 1 - 1938

St. Pl. Ave. Second No. 16

Name of Owner TAX ID
Varney #309.12-10-13

Labor and Mat'l. Report 6-13-38 19

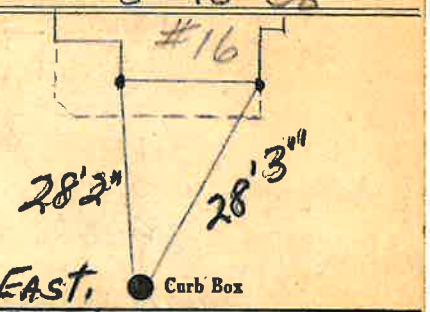

REVERSE BOX - "OFF" IS ON

6" Main Elev. of Main at tap 5"

Gate at • • Gate at

22' to MAIN
3/4" COPPER

• Curb Box

MEASUREMENTS FOR #16 SECOND ST.

Old tap disconnected.

2 - Boxes 1 for #16
1 for #16½R.