Labor and Materials

1	Lead Connection	3/4	$
1	Curb Cock	1	$
1	Service Box (Old returned) { Short 3½ x 4½ / Long 4½ x 6½ / Buffalo }		$
6	Ft. in. G. I. Pipe at	1	$
	Nipples in. at		$
	Bushings to in. at		$
	Red'g Coup to in. at		$
	Inc'g Coup to in. at		$
	Union in. at		$
	Meter in. at		$
	Cu. Yds. Br. Stone at		$
	Cu. Yds. Sand at		$
	Bags Cement at		$
	Paving Brick { Mack / Red / Asphalt } at		$
2.	Hrs. Foreman at		$
2.	Hrs. Common Labor at		$
	Hrs. Mason at		$
	Hrs. at		$
	Hrs. at		$
Gas	Builders' Use of Water		$
	at		$
Truck 10.0	at		$
	at		$
	at		$
	Total		$ 11.28

gully 25

Labor and Material Report 19

43 Second St.

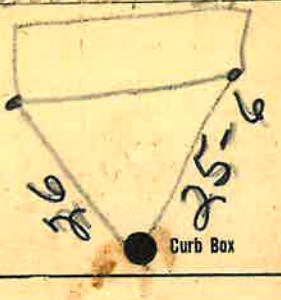

6 Main

Elev. of Main at tap 4½

Gate at ● ● Gate at

TAX ID # 309.11-7-27

● Curb Box

6' to MAIN

¾" LEAD CONN.