Labor and Materials

1	Lead Connection	$
1	Curb Cock	$
1	Service Box Old returned { Short 3½ x 4½ / ~~Long 4½ x 5½~~ / ~~Buffalo~~ }	$
6	Ft. ..... in. G. I. Pipe at	$
	Nipples ..... in. at	$
	Bushings ..... to ..... in. at	$
	Red'g Coup .... to .... in. at	$
	Inc'g Coup .... to .... in. at	$
	Union .... in. at	$
	Meter .... in. at	$
	Cu. Yds. Br. Stone at	$
	Cu. Yds. Sand at	$
	Bags Cement at	$
	Paving Brick { Mack / Red / Asphalt } at	$
2	Hrs. Foreman at	$
	Hrs. Common Labor at	$
	Hrs. Mason at	$
	Hrs. ..... at	$
	Hrs. ..... at	$
9.42	Builders' Use of Water	$
	Truck ..... at	$
	..... at	$
	..... at	$
	..... at	$
	Total	$ 8.86

Labor and Material Report Oct 15 1923

½ Tap ~~7~~ 25 Sheridan St

WEST OF CRANDALL

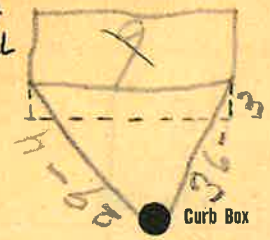

TAX ID # 302.19-5-16

6" Main

Elev. of Main at tap 4'

Gate at ●

● Gate at

● Curb Box

6' to MAIN