Labor and Materials

1	Lead Connection ¾	$	4.69
1	Curb Cock 1	$	1.76
1	Service Box (Old returned) Short 3½ x 4½ / Long 4½ x 5½ / Buffalo	$	1.44
20	Ft. 1 in. PLASTIC Pipe at	$	3.90
	Nipples in. at	$	
	Bushings to in. at	$	
	Red'g Coup to in. at	$	
	Inc'g Coup to in. at	$	
	Union in. at	$	
	Meter in. at	$	
	Cu. Yds. Br. Stone at	$	
	Cu. Yds. Sand at	$	
	Bags Cement at	$	
	Paving Brick (Mack / Red / Asphalt) at	$	
2	Hrs. Foreman at	$	1.32
7	Hrs. Common Labor at	$	2.84
	Hrs. Mason at	$	
	Hrs. at	$	
	Hrs. at	$	
1	Builders' Use of Water	$	1.50
1	truck at	$	1.00
Comp. Use	at	$	.11
	at	$	
	at	$	
	Total	$	16.49

Labor and Material Report 19

Sept 19

25 Chandler St

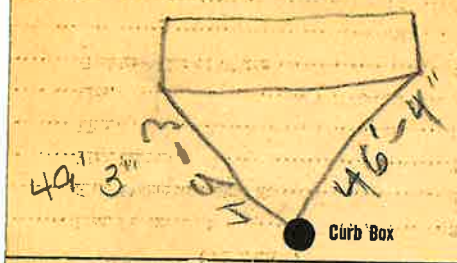

6 Main — Elev. of Main at tap 4½

Gate at — Gate at

TAX ID # 302.19-4-13

Curb Box

20' to MAIN

~~1" GAL.~~

REPLACED GALVANIZED W/PLASTIC 7-5-16