LABOR AND MATERIALS

1	Copper / ~~Lead~~ Connection	3/4	$ 2.29
1	Curb (Cock / Valve / T. S. & V.)	3/4 in.	$ 2.70
1	Service box (~~Old returned~~ / Short 3½x4½ / Long 4½x5½ / Buff or Rdway)		$ 4.25
10 Ft.	3/4 in. (Copper / G. I. / C. I.) Pipe at	35	$ 3.50
	Nipples in. at		$
	Bushings to in. at		$
	Red'g / Inc'g Coupl'gs to in. at		$
	Union in. at		$
	Meter in. at		$
	Lead Joints at		$
	Compound Joints at		$
	Hrs. Water Maint. Man—1 at		$
2	Hrs. Water Maint. Man—2 at	1.02	$ 2.04
21	Hrs. Labor— at	.91	$ 19.11
	Hrs. Labor— at		$
2	Hrs. Compressor at	1.20	$ 2.40
	Compensation Ins. at $ per C.		$ .47
	Trucking		$ 1.47
	Pav't Patch		$ 10.13
	Tap by Mogavero		$
			$
			$
	O'head		$
			$ 47.89

1

St. / ~~Pl.~~ Ave. No. 48

Shonday

Name of Owner

Voorhees

Labor and Mat'l. Report Jan 30 1950

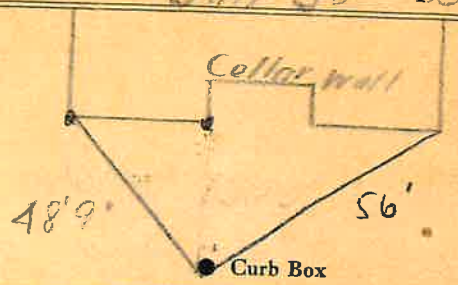

6 Main

Elev. of Main at tap 5'

Gate at ●

● Gate at

TAX ID# 302.19-9-6

● Curb Box

10' to MAIN

3/4" copper

LSM-5C 10-21-49