LABOR AND MATERIALS

1 Copper ~~Lead~~ Connection 3/4		$ 1.31
1 Curb Cock ~~Valve~~ ~~T. S. & V.~~ 3/4 in.		$ 1.75
1 Service Box ~~Old returned~~ Short 3½x4½ Long 4½x5½ ~~Buff. or Rdway~~		$ 1.60
23 Ft. 3/4 in. Copper ~~Galv Iron~~ ~~Cast Iron~~ Pipe at 18		$ 4.14
Nipples in. at		$
Bushings to in. at		$
Red'g Inc'g Couplings to in. at		$
Union in. at		$
Meter in. at		$
Lead Joints at		$
Leadite Joints at		$
Hrs. Foreman at		$
Hrs. Chauffeur at		$
Hrs. Tapper at		$
1 Hrs. Labor at		$ .45
Hrs. Labor at		$
Hrs. Compressor at		$
Compensation Ins.		$ .02
Trucking		$ 1.—
Builders Use of Water ½ Patch (Sewer)		$ 2.50
Taply Hessel		$
		$
		$
		$
		$ 12.77

16 - - 1940

St. ~~Pl.~~ Ave. No. 89

Sheridan

Name of Owner

Lyman

Labor and Mat'l. Report May 8 1940

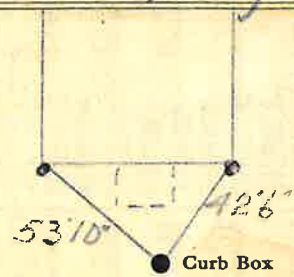

6 Main

Elev. of Main at tap 5

Gate at ● ● Gate at

TAX ID# 302.19-3-9

● Curb Box

23' to MAIN
3/4" COPPER

New House