LABOR AND MATERIALS

1	Copper / ~~Lead~~ Connection 3/4		$ 2.87
1	Curb Cock / ~~Valve~~ / ~~T. S. & V.~~ 3/4 in.		$ 3.62
1	Service box / ~~Old returned~~ Short 3½X4½ / Long 4½X5½ / Buff or Rdway		$ 4.68
13	Ft. 3/4 in. Copper / ~~G. I.~~ / ~~C. I.~~ Pipe at 32		$ 4.16
	Nipples ..... in. at		$
	Bushings ..... to ..... in. at		$
	Red'g / Inc'g Coupl'gs ..... to ..... in. at		$
	Union ..... in. at		$
	Meter ..... in. at		$
	Lead Joints at		$
	Compound Joints at		$
	Hrs. Water Maint. Man—1 at		$
7	Hrs. Water Maint. Man—2 at	1.02	$ 7.14
14	Hrs. Labor— ..... at	91	$ 12.74
	Hrs. Labor— ..... at		$
2	Hrs. Compressor at	1.20	$ 2.40
	Compensation Ins. at $2.18 per C		$ .43
	Trucking		$ 2.00
	Pav't Patch		$ 10.25
	Tap by M of "Hill"		$
			$
			$
	O'head		$
			$ 50.29

5

Sheridan St. Pl. Ave. No. 96

Name of Owner

Ashley

Labor and Mat'l. Report Dec 17 1948

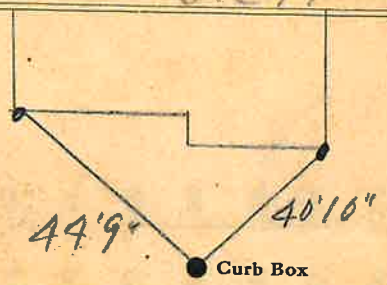

6 Main

Elev. of Main at tap 5

Gate at ● ● Gate at

TAX ID # 302.19-7-6

● Curb Box

13' to MAIN

3/4" COPPER

LSM-5C 5 15-48