LABOR AND MATERIALS

1 Copper ~~Lead~~	Connection 3/4	$ 1.31
1 Curb { Cock / Valve / ~~T. S. & V.~~ }	3/4 in.	$ 1.75
1 Service Box Old returned { Short 3½x4½ / Long 4½x5½ / Buff. or Rdway }		$ 1.60
10 Ft. 3/4 in. { Copper / Galv Iron / Cast Iron }	Pipe at 18	$ 1.80
____ Nipples ____ in. at		$
____ Bushings ____ to ____ in. at		$
____ Red'g / Inc'g } Couplings ____ to ____ in. at		$
____ Union ____ in. at		$
____ Meter ____ in. at		$
____ Lead Joints at		$
____ Leadite Joints at		$
____ Hrs. Foreman at		$
2½ Hrs. Chauffeur at	62½	$ 1.56
1 Hrs. Tapper at	62½	$ .63
9 Hrs. Labor at	45	$ 4.05
____ Hrs. Labor at		$
1 Hrs. Compressor at		$ .63
____ Compensation Ins.		$ .19
____ Trucking		$ 1.—
____ Builders Use of Water		$
Tapped Mueller Before Thru		$
		$
		$
		$
		$ 14.52

8 2 - - 1940

St. ~~Pl.~~ Ave. No. 20

Sherman

Name of Owner

Sturdevan

Labor and Mat'l. Report June 19 1940

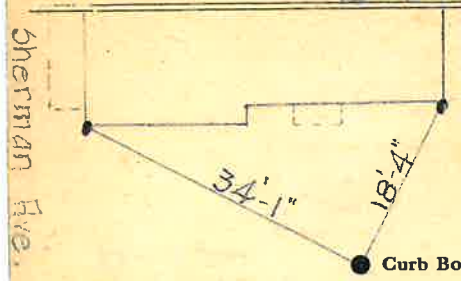

6 Main Elm St. Elev. of Main at tap 6

Gate at ● ● Gate at

TAX ID # 302.20-21-8

● Curb Box

10' to MAIN
3/4" copper