Labor and Materials

	Lead Connection	$
	Curb Cock	$
	Service Box Old returned { Short 3½ x 4½ / Long 4½ x 6½ / ~~Buffalo~~ }	$
	Ft. ..... in. G. I. Pipe at	$
	Nipples ..... in. at	$
	Bushings ..... to ..... in. at	$
	Red'g Coup .... to .... in. at	$
	Inc'g Coup .... to .... in. at	$
	Union .... in. at	$
	Meter .... in. at	$
	Cu. Yds. Br. Stone at	$
	Cu. Yds. Sand at	$
	Bags Cement at	$
	Paving Brick { Mack / Red / Asphalt } at	$
3	Hrs. Foreman at	$
6	Hrs. Common Labor at	$
	Hrs. Mason at	$
	Hrs. ..... at	$
	Hrs. ..... at	$
	Builders' Use of Water	$
	..... at	$
Truck 10.00	..... at	$
	..... at	$
	..... at	$
	Total	$ 9.66

and Material Report Aug 13 19

#26

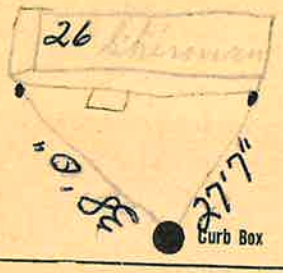

6" Main

Elev. of Main at tap 4'

Gate at ●

● Gate at

● Curb Box

10' to main

3/4" GAL.