Labor and Materials

1 Lead Connection ¾ ..... $.....

1 Curb Cock 3/4 ..... $.....

1 Service Box { Short 3½ x 4½ / ~~Long 4½ x 5½~~ / Buffalo } Old returned ..... $.....

9 Ft. ¾ in. ~~G. I.~~ Copper Pipe at ..... $.....

Nipples ..... in. at ..... $.....

Bushings ..... in. at ..... $.....

Red'g Coup ..... to ..... in. at ..... $.....

Inc'g Coup ..... to ..... in. at ..... $.....

Union ..... in. at ..... $.....

Meter ..... in. at ..... $.....

Cu. Yds. Br. Stone at ..... $.....

Cu. Yds. Sand at ..... $.....

Bags Cement at ..... $.....

Pav. Brick { Mack / Red / Asphalt } at ..... $.....

2 Hrs. Foreman at ..... $.....

8 Hrs. Com. Labor at ..... $.....

Hrs. Mason at ..... $.....

Hrs. ..... at ..... $.....

Hrs. ..... at ..... $.....

Builders' Use of Water ..... $.....

..... at ..... $.....

Truck 1.00 ..... at ..... $.....

..... at ..... $.....

..... at ..... $.....

Total $ 9.65

Labor and Material Report 1923

#30 [illegible] Sherman Ave

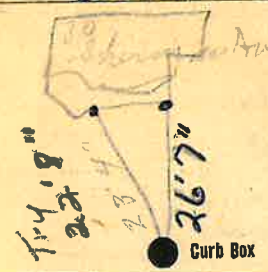

6" Main

Elev. of Main at tap [illegible]

Gate at ● ● Gate at

● Curb Box

9' to main

3/4" copper