Labor and Materials

1	Lead Connection	1/2"	$
1	Curb Cock	3/4"	$
1	Service Box Old returned	Short 3½ x 4½ ~~Long 4½ x 5½~~ Buffalo	$
8	Ft. 3/4	in. G. I. Pipe at	$
	Nipples	in. at	$
	Bushings	in. at	$
	Red'g Coup	to in. at	$
	Inc'g Coup	to in. at	$
	Union	in. at	$
	Meter	in. at	$
	Cu. Yds. Br. Stone at		$
	Cu. Yds. Sand at		$
	Bags Cement at		$
	Pav. Brick (Mack / Red / Asphalt)	at	$
✓	Hrs. Foreman at		$
8	Hrs. Com. Labor at		$
	Hrs. Mason at		$
	Hrs.	at	$
	Hrs.	at	$
35	Builders' Use of Water		$
		at	$
		at	$
Truck 100		at	$
		at	$
		Total	$ 9.53

Labor and Material Report Aug 11 1928

1/2" tap at 6 Sherman Ave

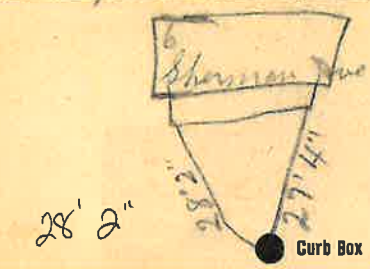

6" Main — Elev. of Main at tap 0-11

Gate at ● ● Gate at

TAX ID# 302.20-21-3

● Curb Box

8' to main

3/4" GAL.