Labor and Materials

1	Lead Connection 3/4"	$
1	Curb Cock 1"	$
1	Service Box Old returned { Short 3½ x 4½ / Long 4½ x 5½ / Buffalo	$
7	Ft. 1" in. G. I. Pipe at	$
	Nipples in. at	$
	Bushings 1" to 1/2" in. at	$
	Red'g Coup to in. at	$
	Inc'g Coup to in. at	$
	Union in. at	$
	Meter in. at	$
	Cu. Yds. Br. Stone at	$
	Cu. Yds. Sand at	$
	Bags Cement at	$
	Paving Brick { Mack / Red / Asphalt } at	$
3	Hrs. Foreman at	$
13	Hrs. Common Labor at	$
	Hrs. Mason at	$
	Hrs. at	$
	Hrs. at	$
20	Builders' Use of Water	$
	at	$
	Truck 100 at	$
	at	$
	at	$
	Total	$ 14.24

Labor and Material Report

Sept 24 19 24

3/4 tap at 4 Sherman Ave

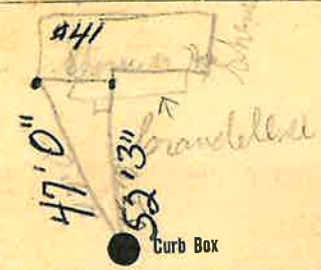

10" Main

Elev. of Main at tap 4 1/2

Gate at ● ● Gate at

TAX ID # 302.20-14-18

● Curb Box

7' to main

1" GAL.