Labor and Materials

	~~Lead~~ Cop Connections 3/4'	$
1	Curb Cock 3/4	$
1	Service Box Old returned { Short 3½ x 4½ / ~~Long 4½~~ x 5½ / ~~Buffalo~~	$
10	Ft. 3/4 in. ~~G.I.~~ Cop Pipe at	$
	Nipples ..... in. at	$
	Bushings ..... to ..... in. at	$
	Red'g Coup .... to .... in. at	$
	Inc'g Coup .... to .... in. at	$
	Union .... in. at	$
	Meter .... in. at	$
	Cu. Yds. Br. Stone at	$
	Cu. Yds. Sand at	$
	Bags Cement at	$
	Paving Brick { Mack / Red / Asphalt } at	$
1½	Hrs. Foreman at	$
6½	Hrs. Common Labor at	$
	Hrs. Mason at	$
	Hrs. ..... at	$
	Hrs. ..... at	$
	Builders' Use of Water	$
	..... at	$
	..... at	$
	..... at	$
	..... at	$
	Total	$ 1240

Labor and Material Report 1925

Lot 46 Sherman

House 44

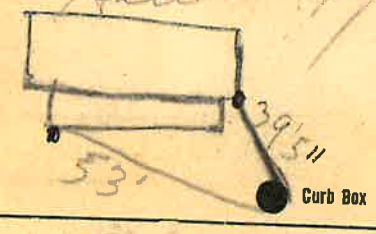

Main

Elev. of Main at tap

Gate at

Gate at

TAX ID # 302.20-19-5

10' to MAIN

3/4" COPPER