Labor and Materials

1 Cop Lead Connection 3/4 ..... $.....

1 Curb Cock 3/4 ..... $.....

1 Service Box { Short 3½ x 4½ / ~~Long 4½ x 5½~~ / ~~Buffalo~~ } Old returned ..... $.....

26 Ft. 3/4 in. G. I. Pipe at Cop ..... $.....

.....Nipples.....in. at..... $.....

1 Bushings 1/2 to 3/4 in. at..... $.....

.....Red'g Coup....to....in. at..... $.....

.....Inc'g Coup....to....in. at..... $.....

.....Union....in. at..... $.....

.....Meter....in. at..... $.....

.....Cu. Yds. Br. Stone at..... $.....

.....Cu. Yds. Sand at..... $.....

.....Bags Cement at..... $.....

.....Paving Brick { Mack / Red / Asphalt } at..... $.....

2¼ Hrs. Foreman at ..... $.....

16¾ Hrs. Common Labor at..... $.....

.....Hrs. Mason at..... $.....

.....Hrs.....at..... $.....

.....Hrs.....at..... $.....

No Builders' Use of Water ..... $.....

.....at..... $.....

.....at..... $.....

.....at..... $.....

.....at..... $.....

Total $ 19.42

Labor and Material Report 1925

[illegible] Sherwood Ave. 49

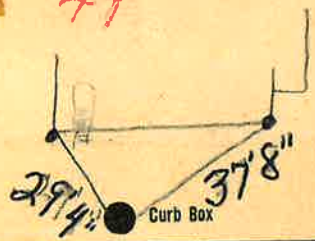

Main 37.8 29.4 Elev. of Main at tap

Gate at ● ● Gate at

TAX ID # 302.19-28-32

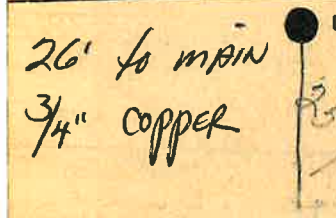

26' to main

3/4" copper