Labor and Materials

	~~Lead~~ Connection	$
1	Curb Cock	$
1	Service Box (Short 3½ x 4) / Old returned (~~Long 41 x 5~~ / ~~Buffalo~~)	$
25 Ft.	in. G. I. Pipe at	$
	Nipples in. at	$
1	Bushings to in. at	$
	Red'g Coup to in. at	$
	Inc'g Coup to in. at	$
	Union in. at	$
	Meter in. at	$
	Cu. Yds. Br. Stone at	$
	Cu. Yds. Sand at	$
	Bags Cement at	$
	Paving Brick (Mack / Red / Asphalt) at	$
1½	Hrs. Foreman at	$
11½	Hrs. Common Labor at	$
	Hrs. Mason at	$
	Hrs. at	$
	Hrs. at	$
No.	Builders' Use of Water at	$
	at	$
	at	$
	at	$
	Total	$ 17.02

Labor and Material Report 1925

3-5 Sherman Ave.

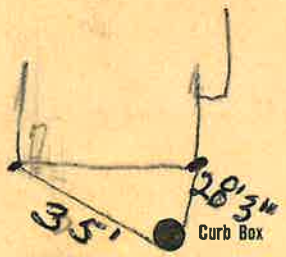

Main — Elev. of Main at tap

Gate at ● ● Gate at

TAX ID # 302.19-28-29

25' to main
3/4" Copper