Labor and Materials

	~~Lead~~ Cop Connection 3/4	$
1	Curb Cock 3/4	$
1	Service Box Old returned { Short 3½ x 4½ ~~Long 4½ x 5½~~ ~~Buffalo~~	$
25	Ft. 1/4 in. G. I. Pipe at Cop	$
	Nipples in. at	$
1	Bushings to in. at	$
1	Red'g Coup to 3/4 in. at	$
	Inc'g Coup to in. at	$
	Union in. at	$
	Meter in. at	$
	Cu. Yds. Br. Stone at	$
	Cu. Yds. Sand at	$
	Bags Cement at	$
	Paving Brick { Mack Red Asphalt } at	$
2 1/4	Hrs. Foreman at	$
10 3/4	Hrs. Common Labor at	$
	Hrs. Mason at	$
	Hrs. at	$
	Hrs. at	$
NO	Builders' Use of Water	$
	at	$
	at	$
	at	$
	at	$
	Total	$

Labor and Material Report 1925

Lot 57 Sherman Ave.

House 55 Sherman

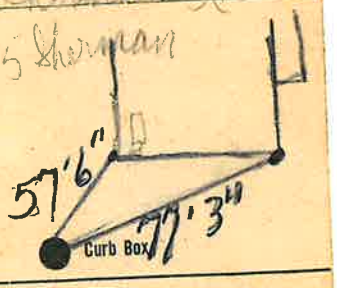

57'6 . 77'3"

Main

Elev. of Main at tap

Gate at ● ● Gate at

TAX ID # 302.19-28-28

25' to main
3/4" copper