Labor and Materials

- Lead Connection ¾ cop ..... $
- 1 Curb Cock ¾ ..... $
- 1 Service Box { Short 3½ x 4½ / ~~Long 4½ x 5½~~ / ~~Buffalo~~ } Old returned ..... $
- 28 Ft. ¾ in. G. I. Pipe at cop ..... $
- Nipples ..... in. at ..... $
- 1 Bushings ½ to ¾ in. at ..... $
- Red'g Coup .... to .... in. at ..... $
- Inc'g Coup .... to .... in. at ..... $
- Union .... in. at ..... $
- Meter .... in. at ..... $
- Cu. Yds. Br. Stone at ..... $
- Cu. Yds. Sand at ..... $
- Bags Cement at ..... $
- Paving Brick { Mack / Red / Asphalt } at ..... $
- 2¼ Hrs. Foreman at ..... $
- 13 Hrs. Common Labor at ..... $
- Hrs. Mason at ..... $
- Hrs. ..... at ..... $
- Hrs. ..... at ..... $
- NO Builders' Use of Water ..... $
- ..... at ..... $
- ..... at ..... $
- ..... at ..... $
- ..... at ..... $

Total $ 1830

Labor and Material Report 1925

59 Sherman Ave

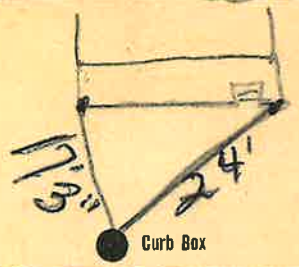

34 17

Main — Elev. of Main at tap

Gate at ● ● Gate at

TAX ID # 302.19-28-27

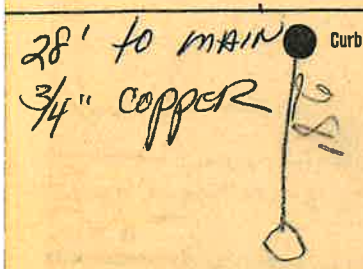

OUTSIDE CLEANOUT LOCATED ON SIDE OF HOUSE 3'8" OFF WALL