Labor and Materials

	~~Lead~~ Connection cop 3/4	$
1	Curb Cock 3/4	$
1	Service Box { Short 3½ x 4½ / Old returned ~~Long 4½ x 6½~~ ~~Buffalo~~ }	$
9	Ft. 3/4 in. G. I. Pipe at cop	$
	Nipples ..... in. at	$
X	Bushings ..... to ..... in. at	$
	Red'g Coup .... to .... in. at	$
	Inc'g Coup .... to .... in. at	$
	Union .... in. at	$
	Meter .... in. at	$
	Cu. Yds. Br. Stone at	$
	Cu. Yds. Sand at	$
	Bags Cement at	$
	Paving Brick { Mack / Red / Asphalt } at	$
1½	Hrs. Foreman at	$
10¾	Hrs. Common Labor at	$
	Hrs. Mason at	$
	Hrs. ..... at	$
	Hrs. ..... at	$
	Builders' Use of Water	$
	..... at	$
	..... at	$
	..... at	$
	..... at	$
	Total	$ 12.70

Labor and Material Report 19

62 Sherman Ave.

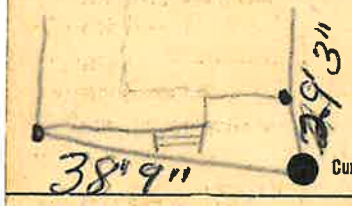

TAX ID # 302.20-19.11

Main

Elev. of Main at tap

Gate at ●

● Gate at