Labor and Materials

	Lead Connection	3/4	$
1	Curb Cock	3/4	$
1	Service Box { Short 3½ x 4½ / ~~Old returned~~ Long 4½ x 5½ / Buffalo }		$
28	Ft. 3/4 in. ~~G. I.~~ Cop Pipe at		$
	Nipples ... in. at		$
1	Bushings ... to 2 in. at		$
	Red'g Coup ... to ... in. at		$
	Inc'g Coup ... to ... in. at		$
	Union ... in. at		$
	Meter ... in. at		$
	Cu. Yds. Br. Stone at		$
	Cu. Yds. Sand at		$
	Bags Cement at		$
	Paving Brick { Mack / Red / Asphalt } at		$
3	Hrs. Foreman at		$
13	Hrs. Common Labor at		$
	Hrs. Mason at		$
	Hrs. ... at		$
	Hrs. ... at		$
no	Builders' Use of Water		$
	Trucks at		$
	~~———~~ at		$
	at		$
	Total		$

Labor and Material Report June 16 1925

65 Sherman Ave.

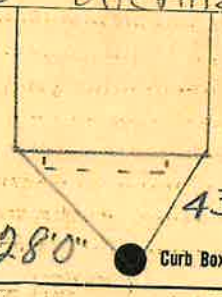

6" Main — Elev. of Main at tap

Gate at ● — ● Gate at

TAX ID # 302.19-28-25

28' to main ● Curb Box

3/4" copper