Labor and Materials

1	~~Lead~~ Connection 3/4	$
1	Curb Cock 3/4	$
1	Service Box Old returned { Short 3½ x 4½ / ~~Long~~ 4½ x 5½ / ~~Buffalo~~	$
8	Ft. Cop in. G. I. Pipe at	$
	Nipples ..... in. at	$
	Bushings ..... to ..... in. at	$
	Red'g Coup .... to .... in. at	$
	Inc'g Coup .... to .... in. at	$
	Union .... in. at	$
	Meter .... in. at	$
	Cu. Yds. Br. Stone at	$
	Cu. Yds. Sand at	$
	Bags Cement at	$
	Paving Brick { Mack / Red / Asphalt } at	$
2	Hrs. Foreman at	$
5	Hrs. Common Labor at	$
	Hrs. Mason at	$
	Hrs. ..... at	$
	Hrs. ..... at	$
9W	Builders' Use of Water	$
	..... at	$
	Truck 100 ..... at	$
	..... at	$
	..... at	$
	Total	$ 10.33

Labor and Material Report 19 78

3/4 Tap 72 Sheriff [illegible]

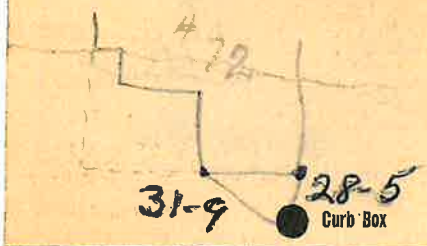

6" Main

Elev. of Main at tap 4½'

Gate at

Gate at

TAX ID# 309.7-9-11

Curb Box

8" to MAIN

3/4" copper