Labor and Materials

	~~Lead~~ Cop Connection 3/4	$
1	Curb Cock	$
1	Service Box Old returned { ~~[illegible]~~ Long 4½ x 5½ ~~Buffalo~~	$
29	Ft. 3/4 in. G. I. Pipe at cop	$
	Nipples ..... in. at	$
	Bushings ..... to ..... in. at	$
	Red'g Coup .... to .... in. at	$
	Inc'g Coup .... to .... in. at	$
	Union .... in. at	$
	Meter .... in. at	$
	Cu. Yds. Br. Stone at	$
	Cu. Yds. Sand at	$
	Bags Cement at	$
	Paving Brick { Mack Red Asphalt } at	$
2¼	Hrs. Foreman at	$
11¾	Hrs. Common Labor at	$
	Hrs. Mason at	$
	Hrs. ..... at	$
	Hrs. ..... at	$
No	Builders' Use of Water	$
	at	$
	at	$
	at	$
	at	$
	Total	$ 19.32

Labor and Material Report 19

Lot. 75 Sherman Ave

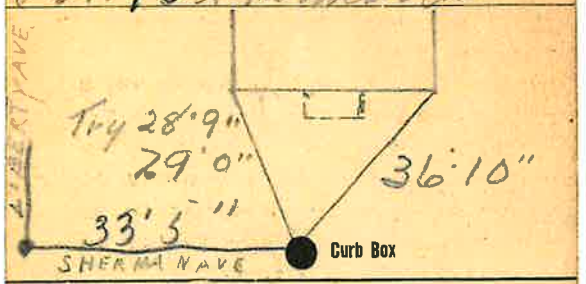

TAX ID# 302.19-28-21

Main

Elev. of Main at tap

Gate at ● ● Gate at

29' to MAIN
3/4" COPPER