Labor and Materials

	Cop ~~Lead~~ Connection 3/4	$
1	Curb Cock 3/4	$
1	Service Box Old returned { Short 3½ x 4½ ~~Long 4½ x 5½~~ ~~Buffalo~~	$
9	Ft. 3/4 in. Cop ~~G.I.~~ Pipe at	$
	Nipples ..... in. at	$
X	Bushings ..... to ..... in. at	$
X	Red'g Coup ½ to 3/4 in. at	$
	Inc'g Coup .... to .... in. at	$
	Union .... in. at	$
	Meter .... in. at	$
	Cu. Yds. Br. Stone at	$
	Cu. Yds. Sand at	$
	Bags Cement at	$
	Paving Brick { Mack Red Asphalt } at	$
1½	Hrs. Foreman at	$
7	Hrs. Common Labor at	$
	Hrs. Mason at	$
	Hrs. ..... at	$
	Hrs. ..... at	$
	Builders' Use of Water	$
	at	$
	at	$
	at	$
	at	$
	Total	$ 11.29

Labor and Material Report 19

76 Sherman Ave.

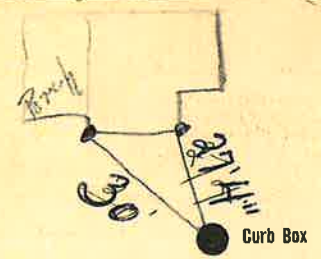

TAX ID # 309.7-8-11

6" Main

Elev. of Main at tap

Gate at ● ● Gate at

9' to MAIN
3/4" COPPER