		$
	in.	Pipe at $
Nipples	in.	at $
Bushings	to in.	at $
Red'g Coup	to in.	at $
Inc'g Coup	to in.	at $
Union	in.	at $
Meter	in.	at $
Cu. Yds. Br. Stone		at $
Cu. Yds. Sand		at $
Bags Cement		at $
Paving Brick { Mack / Red / Asphalt }		at $
1½ Hrs. Foreman		at $
7½ Hrs. Common Labor		at $
Hrs. Mason		at $
Hrs.		at $
Hrs.		at $
Builders' Use of Water		$
		at $
		at $
		at $
		at $
		$ 11.25

Labor and Materia. G 19

78 Sherman Ave

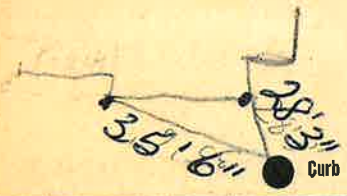

TAX ID# 309.7-8-12

Main

Elev. of Main at tap

Gate at ●

● Gate at

Curb Box