Labor and Materials

Cop

- Lead Connection ¾ ..... $
- 1 Curb Cock ¾ ..... $
- 1 Service Box { ~~Short Sizes~~ / Long 4½ x 5½ / ~~Buffalo~~ } Old returned ..... $
- 28 Ft. ¾ in. G. I. Pipe at Cop. ..... $
- Nipples ..... in. at ..... $
- Bushings ..... to ..... in. at ..... $
- 1 Red'g Coup .... to ¾ in. at ..... $
- Inc'g Coup .... to .... in. at ..... $
- Union .... in. at ..... $
- Meter .... in. at ..... $
- Cu. Yds. Br. Stone at ..... $
- Cu. Yds. Sand at ..... $
- Bags Cement at ..... $
- Paving Brick { Mack / Red / Asphalt } at ..... $
- 2 Hrs. Foreman at ..... $
- 4 Hrs. Common Labor at ..... $
- Hrs. Mason at ..... $
- Hrs. ..... at ..... $
- Hrs. ..... at ..... $
- 20 Builders' Use of Water ..... $
- TRUCK 100 ..... at ..... $
- ..... at ..... $
- ..... at ..... $
- ..... at ..... $

Total $ 1.87

Lot 83 Shumard Ave.

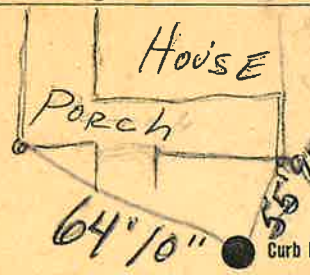

Jorge & Herman

64'10"

Main — Elev. of Main at tap

Gate at ● — ● Gate at

22' to MAIN
3/4" COPPER