Labor and Materials

	~~Lead~~ Cop. Connection 3/4	$
1	Curb Cock 3/4	$
1	Service Box Old returned { ~~Short 3½ x 4½~~ Long 4½ x 5½ ~~Buffalo~~	$
28	Ft. 3/4 in. G. I. Pipe at Copp.	$
	Nipples in. at	$
	Bushings to in. at	$
1	Red'g Coup to 3/4 in. at	$
	Inc'g Coup to in. at	$
	Union in. at	$
	Meter in. at	$
	Cu. Yds. Br. Stone at	$
	Cu. Yds. Sand at	$
	Bags Cement at	$
	Paving Brick { Mack Red Asphalt } at	$
2	Hrs. Foreman at	$
13	Hrs. Common Labor at	$
	Hrs. Mason at	$
	Hrs. at	$
	Hrs. at	$
NO	Builders' Use of Water	$
	at	$
	at	$
	at	$
	at	$
	Total	$ 19.78

Labor and Material Report 19

Lot 85 Sherman Ave.

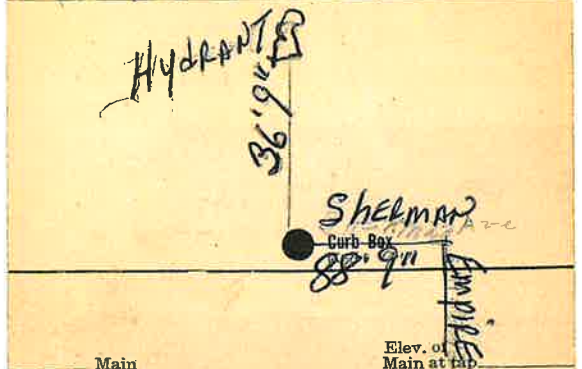

Main

Elev. of Main at tap

Gate at

Gate at

28' to MAIN 3/4" COPPER