LABOR AND MATERIALS

1	Copper ~~Lead~~ Connection	3/4	$ 1.35
1	Curb { Cock Valve T. S. & V. }	3/4 in.	$ 1.80
1	Service Box Old returned { Short 3½x4½ Long 4½x5½ Buffor Rdway }		$ 1.70
21 Ft.	3/4 in. { Copper Galv Iron Cast Iron } Pipe at	18	$ 3.78
	Nipples in. at		$
	Bushings to in. at		$
	Red'g Inc'g Couplings to in. at		$
	Union in. at		$
	Meter in. at		$
	Lead Joints at		$
	Leadite Joints at		$
	Hrs. Foreman at		$
3	Hrs. Chauffeur at	62½	$ 1.87
3	Hrs. Tapper at	"	$ 1.88
15	Hrs. Labor at	.45	$ 6.75
	Hrs. Labor at		$
2	Hrs. Compressor at	.62½	$ 1.25
	Compensation Ins.		$ .32
	Trucking		$ 1.—
	Builders Use of Water	Sketch	$ .9—
	Trip Time		$
			$
			$
			$
			$ 30.70

3 6 1941

~~St.~~ Pl.

Sherman Ave. No. 15

Name of Owner

Scates

Labor and Mat'l. Report June 2 1941

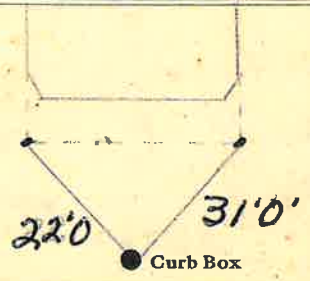

6 Main

Elev. of Main at tap 5

Gate at ● ● Gate at

TAX ID # 302.20-15.12

● Curb Box

21' to MAIN

3/4" COPPER