Labor and Materials

	~~Lead~~ cop Connection 3/4	$
1	Curb Cock 3/4	$
1	Service Box Old returned { Short 3½ x 4½ / ~~Long 4½ x 5½~~ / Buffalo }	$
9	Ft. 3/4 in. G. I. Pipe at cop	$
	Nipples ..... in. at	$
	Bushings ..... to ..... in. at	$
	Red'g Coup .... to .... in. at	$
	Inc'g Coup .... to .... in. at	$
	Union .... in. at	$
	Meter .... in. at	$
	Cu. Yds. Br. Stone at	$
	Cu. Yds. Sand at	$
	Bags Cement at	$
	Paving Brick { Mack / Red / Asphalt } at	$
1½	Hrs. Foreman at	$
4	Hrs. Common Labor at	$
	Hrs. Mason at	$
	Hrs. ..... at	$
	Hrs. ..... at	$
	Builders' Use of Water	$
	at	$
	at	$
	at	$
	at	$
	Total	$ 11.13

Labor and Material Report 19

92 Sherman Ave.

Donovan Lot

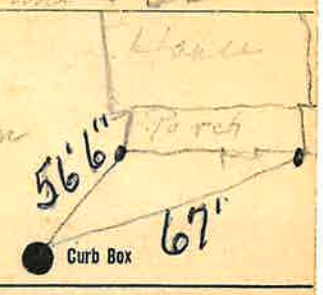

56'6"

Main

Elev. of Main at tap

Gate at ● ● Gate at

9' to MAIN
3/4" copper