Labor and Materials

	Lead Connection 3/4	$
1	Curb Cock 3/4	$
	Service Box Old returned { Short 3½ x 4½ / ~~Long 4½ x 5½~~ / Buffalo }	$
26	Ft. in. G. I. Pipe at	$
	Nipples in. at	$
	Bushings to in. at	$
	Red'g Coup to in. at	$
	Inc'g Coup to in. at	$
	Union in. at	$
	Meter in. at	$
	Cu. Yds. Br. Stone at	$
	Cu. Yds. Sand at	$
	Bags Cement at	$
	Paving Brick { Mack / Red / Asphalt } at	$
2¼	Hrs. Foreman at	$
9	Hrs. Common Labor at	$
	Hrs. Mason at	$
	Hrs. at	$
	Hrs. at	$
	Builders' Use of Water	$
	at	$
	at	$
	at	$
	at	$
	Total	$ 1742

Labor and Material Report 19

Lot 1 - Quade's Near Quade St.

101 Sherman

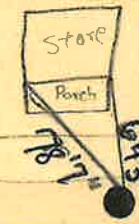

Measured From 110 Sherman

Sherman Ave

Main

Elev. of Main at tap

Gate at

Gate at

26' to MAIN