Labor and Materials

Lead Connection	3/4	$
Curb Cock	3/4	$
Service Box Old returned { Short 3½ x 4½ / Long 4½ x 5½ / Buffalo-		$
27 Ft. 3/4 in. G. I. Pipe at		$
Nipples ... in. at		$
Bushings ... to ... in. at		$
Red'g Coup ... to ... in. at		$
Inc'g Coup ... to ... in. at		$
Union ... in. at		$
Meter ... in. at		$
Cu. Yds. Br. Stone at		$
Cu. Yds. Sand at		$
Bags Cement at		$
Paving Brick { Mack / Red / Asphalt } at		$
2 4/9 Hrs. Foreman at		$
Hrs. Common Labor at		$
Hrs. Mason at		$
Hrs.	at	$
Hrs.	at	$
Builders' Use of Water		$
	at	$
	at	$
	at	$
	at	$
Total		$ 17.64

Double Lot No. 4

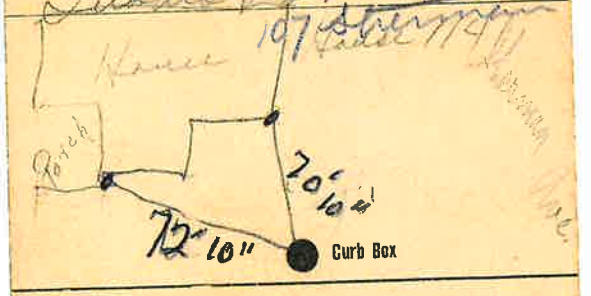

Main — Elev. of Main at tap

Gate at ● — ● Gate at

27' to MAIN
3/4" GAL