Labor and Materials

1 Lead Connection 3/4 ..... $
1 Curb Cock ..... $
1 Service Box / Old returned { Short 3½ x 4½ / Long 4½ x 5½ / Buffalo } ..... $
7 Ft. 1 in. G. I. Pipe at ..... $
Nipples ..... in. at ..... $
Bushings ..... to ..... in. at ..... $
Red'g Coup ..... to ..... in. at ..... $
Inc'g Coup ..... to ..... in. at ..... $
Union ..... in. at ..... $
Meter ..... in. at ..... $
Cu. Yds. Br. Stone at ..... $
Cu. Yds. Sand at ..... $
Bags Cement at ..... $
Paving Brick { Mack / Red / Asphalt } at ..... $
2 Hrs. Foreman at ..... $
2 Hrs. Common Labor at .50 ..... $
Hrs. Mason at ..... at ..... $
Hrs. ..... at ..... $
Hrs. ..... $
Builders' Use of Water NO. ..... at ..... $
Trench ..... at ..... $
..... at ..... $
..... at ..... $
Total $ 10.22

Labor and Material Report

Nov 11 19 34

3/4 tap at 108 Sherman Ave

6" Main

Elev. of Main at tap 4'

Gate at 7' to MAIN

Gate at

Curb Box

House Torn Down
TAX ID# 309.7-7-9

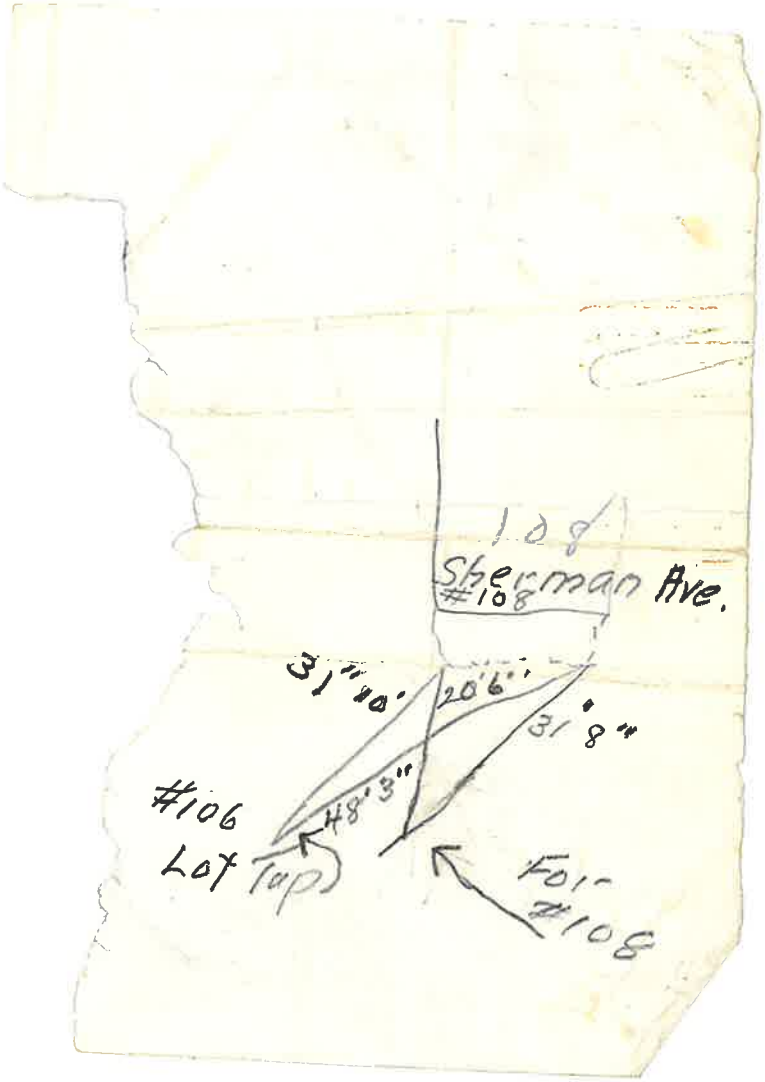
108
Sherman Ave.
#108
31'10"
20'6"
31'8"
#106
Lot Top
48'3"
For
#108