Labor and Materials

	Lead Connection	$
1	Curb Cock 3/4	$
1	Service Box Old returned { Short 3½ x 4½ / ~~Long 4½ x 5½~~ / ~~Buffalo~~ }	$
10	Ft. 3/4 in. G. I. Pipe at cop.	$
	Nipples in. at	$
1	Bushings to in. at	$
1	Red'g Coup to in. at	$
	Inc'g Coup to in. at	$
	Union in. at	$
	Meter in. at	$
	Cu. Yds. Br. Stone at	$
	Cu. Yds. Sand at	$
	Bags Cement at	$
	Paving Brick { Mack / Red / Asphalt } at	$
1½	Hrs. Foreman at	$
14¼	Hrs. Common Labor at	$
	Hrs. Mason at	$
	Hrs. at	$
	Hrs. at	$
	Builders' Use of Water	$
	at	$
	at	$
	at	$
	at	$
	Total	$ 14.44

Labor and Material Report - 19

114 Sherman Ave -

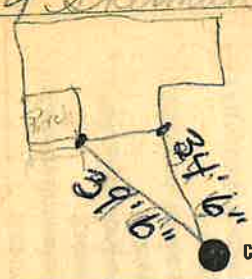

TAX ID# 309.7-6-13

Main

Elev. of Main at tap

Gate at

Gate at

10' to main

3/4" copper