Labor and Materials

Cop 3/4

Lead Connection ..... $

1 Curb Cock 3/4 ..... $

1 Service Box Old returned { Short 3½ x 4½ / ~~Long 4½ x 5½~~ / ~~Buffalo~~ } ..... $

12 Ft. 3/4 in. G. I. Pipe at Cop ..... $

Nipples ..... in. at ..... $

x Bushings ..... to ..... in. at ..... $

Red'g Coup ..... to ..... in. at ..... $

1 Inc'g Coup ..... to 3/4 in. at ..... $

Union ..... in. at ..... $

Meter ..... in. at ..... $

Cu. Yds. Br. Stone at ..... $

Cu. Yds. Sand at ..... $

Bags Cement at ..... $

Paving Brick { Mack / Red / Asphalt } at ..... $

1½ Hrs. Foreman at ..... $

Hrs. Common Labor at ..... $

Hrs. Mason at ..... $

Hrs. ..... at ..... $

Hrs. ..... at ..... $

Builders' Use of Water ..... $

..... at ..... $

..... at ..... $

..... at ..... $

..... at ..... $

Total $ 12.48

Labor and Material Report 1929

116 Sherman Ave

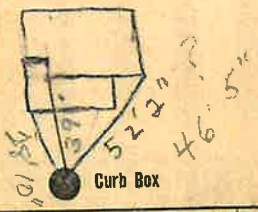

TAX ID# 309.7-6-14

6" Main

Elev. of Main at tap

Gate at ● ● Gate at

12' to main
3/4" copper