LABOR AND MATERIALS

1	Copper / ~~Lead~~ Connection 3/4"	$ 2.41
1	Curb { Cock / ~~Valve~~ / ~~T. S. & V.~~ } 3/4 in.	$ 3.41
1	Service box / ~~Old returned~~ { Short 3½ x 4½ / ~~Long 4½ x 5½~~ / ~~Buff or Rdway~~ }	$ 4.18
23	Ft. 3/4 in. { Copper / ~~C. I.~~ / ~~G. I.~~ } Pipe at 40	$ 9.20
	Nipples ____ in. at	$
	Bushings ____ to ____ in. at	$
	Red'g / Inc'g Coupl'gs ____ to ____ in. at	$
	Union ____ in. at	$
	Meter ____ in. at	$
	Lead Joints at	$
	Compound Joints at	$
	Maintenance Foreman	$
	Hrs. Water Maint. Man—1 at	$
	Hrs. Water Maint. Man—2 at	$
1	Hrs. Garage Foreman at	$ 1.59
17	Hrs. Labor— at 1.13	$ 19.21
	Hrs. Compressor at	$
	Compensation Ins. at $3.861 per C	$ .90
	Trucking	$ 1.50
	Pav't Patch	$ 12.60
Tap by Lareau 9-27-54		$
		$
		$
	O'head	$
		$ 54.90

42.30

25.80

St.
Pl.
Ave. Sherman No. 118

Name of Owner

Kreiser

Labor and Mat'l. Report Sept. 27 1954

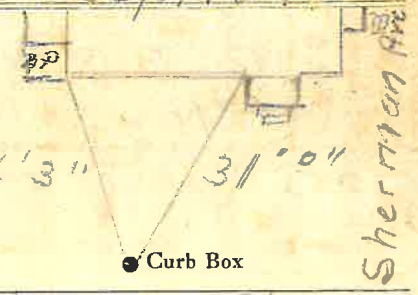

Stevens St.

4" Main

Elev. of Main at tap 5'

Gate at • • Gate at

23' to MAIN
3/4" COPPER

• Curb Box

TAP ON Stevens St.
Inside of Sidewalk
TAX ID # 309.7-5-8

M—5C—2-1-54