Labor and Materials

	~~Lead~~ Connection 3/4	$
1	Curb Cock 3/4	$
NO	Service Box ~~Old returned~~ { Short 3½ x 4½ / Long 4½ x 5½ / Buffalo }	$
8	Ft. in. G. I. Pipe at	$
	Nipples in. at	$
	Bushings ½ to 3/4 in. at	$
1	Red'g Coup to ¾ in. at	$
	Inc'g Coup to in. at	$
	Union in. at	$
	Meter in. at	$
	Cu. Yds. Br. Stone at	$
	Cu. Yds. Sand at	$
	Bags Cement at	$
	Paving Brick { Mack / Red / Asphalt } at	$
1½	Hrs. Foreman at	$
10¼	Hrs. Common Labor at	$
	Hrs. Mason at	$
	Hrs. at	$
	Hrs. at	$
NO	Builders' Use of Water	$
	at	$
	at	$
	at	$
	at	$
	Total	$ 12.43

Labor and Material Report 1925

122 Sherman Ave.

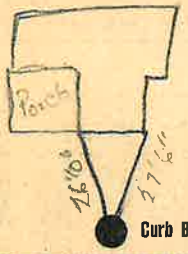

TAX ID # 309.7-5-10

6" Main

Elev. of Main at tap 4½'

Gate at ●

● Gate at