Labor and Materials

1	Copper / ~~Lead~~ Connection	3/4"	$ 1.46
1	Curb: Cock / Valve / T. S. & V.	3/4" in	$ 1.93
1	Service Box Old returned: Short 3½ x 4½ / ~~Long 4½ x 5½~~ / ~~Buff. or Rdway~~		$ 1.77
29	Ft. 3/4" in. Copper / ~~Galv Iron~~ / ~~Cast Iron~~ Pipe at		$ 6.38
	Nipples in. at		$
	Bushings to in. at		$
	Red'g Inc'g Couplings to in. at		$
	Union in. at		$
	Meter in. at		$
	Lead Joints at		$
	Leadite Joints at		$
	Hrs. Foreman at		$
3	Hrs. Chauffeur at	62½	$ 1.88
8	Hrs. Tapper at	62½	$ 5.00
8	Hrs. Labor at	45	$ 3.60 10.48
	Hrs. Labor at		$
	Hrs. Compressor at		$
	Compensation Ins.		$ .32
	Trucking		$ 1.00
	Builders Use of Water	Patch	$ 5.00
			$
			$
			$
	Tap made by hand		$
			$ 28.34

St. / ~~Pl.~~ Ave. No. 14

Shippey

Name of Owner

Dorsey

Labor and Mat'l. Report July 24 1957

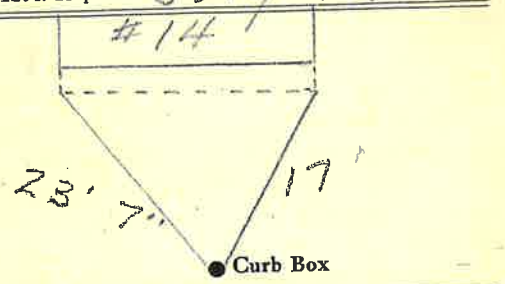

6" Main

Elev. of Main at tap 5'

Gate at ● ● Gate at

6' to main

3/4" copper ● Curb Box

TAX ID # 302.19-25-8

LSM—5C—2-5-56